




2886 EAST BLUE STAR STREET
ANAHEIM, CA 92806

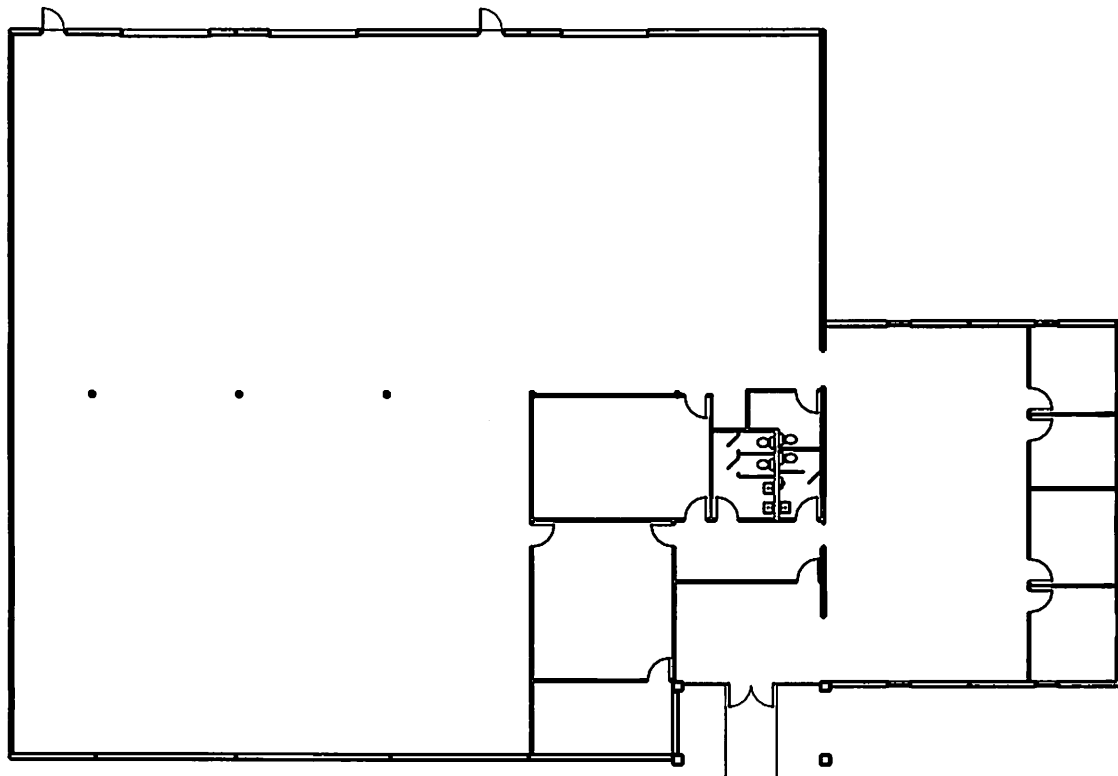

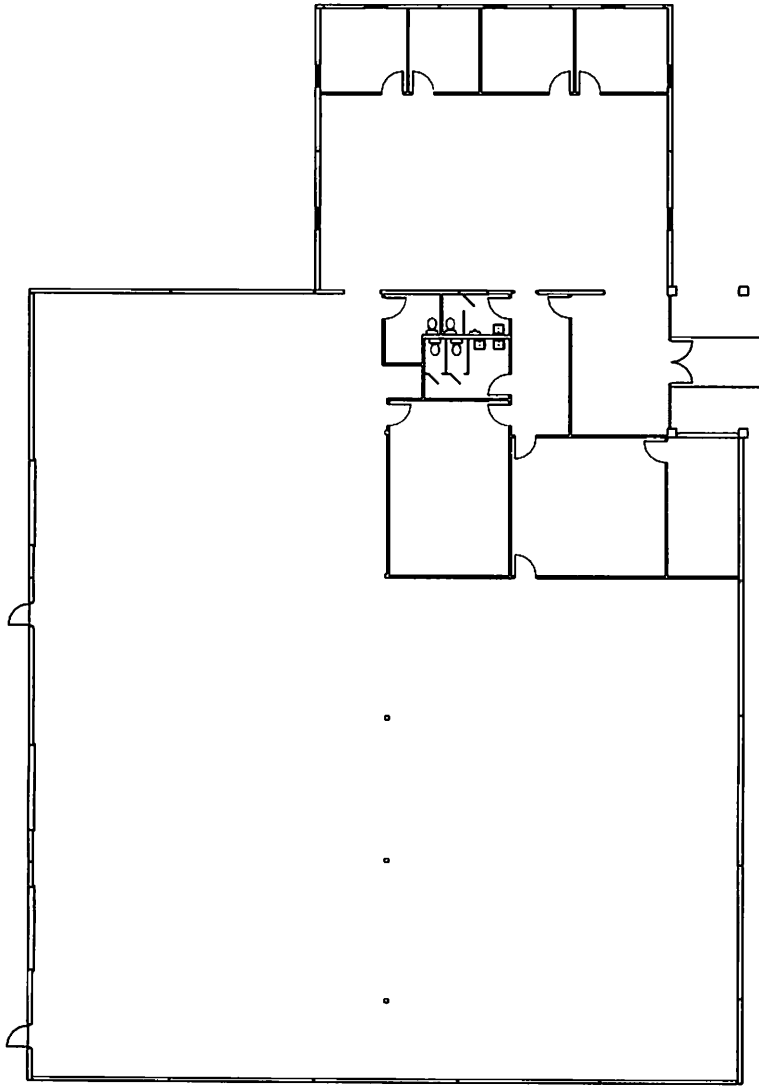

FLOOR PLAN

SCALE: 1/8"=1'-0"

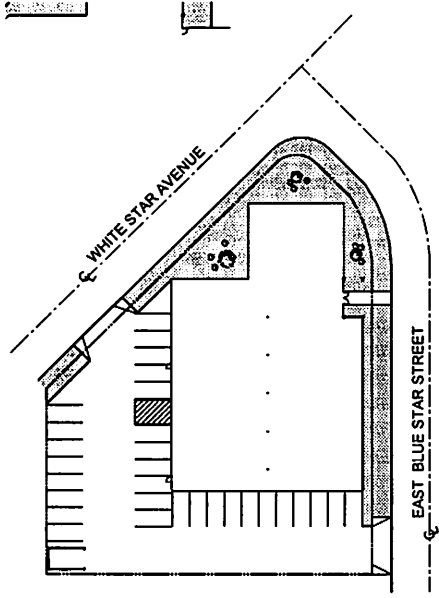

SITE PLAN

SCALE: 1/8"=50'-0"



NO.	REVISIONS	DATE



Bryan Industrial Properties, Inc.

148 East Orangeburg Avenue
 Anaheim, CA 92805
 714.971.1314 Fax 714.969.3725
 www.bryanindprop.com
 ANAHEIM (714) 971-1314 • LOS ANGELES (213) 828-8835 • PHOENIX (602) 378-8284

DESCRIPTION:

2886 E. BLUE STAR STREET
 ANAHEIM, CA 92806

SHEET TITLE:

AS-BUILT FLOOR PLAN


DATE: 11-06-17

FILE NO: CA1705-D

SHEET: 1

OF: 1

2886 EAST BLUE STAR STREET
ANAHEIM, CA 92806

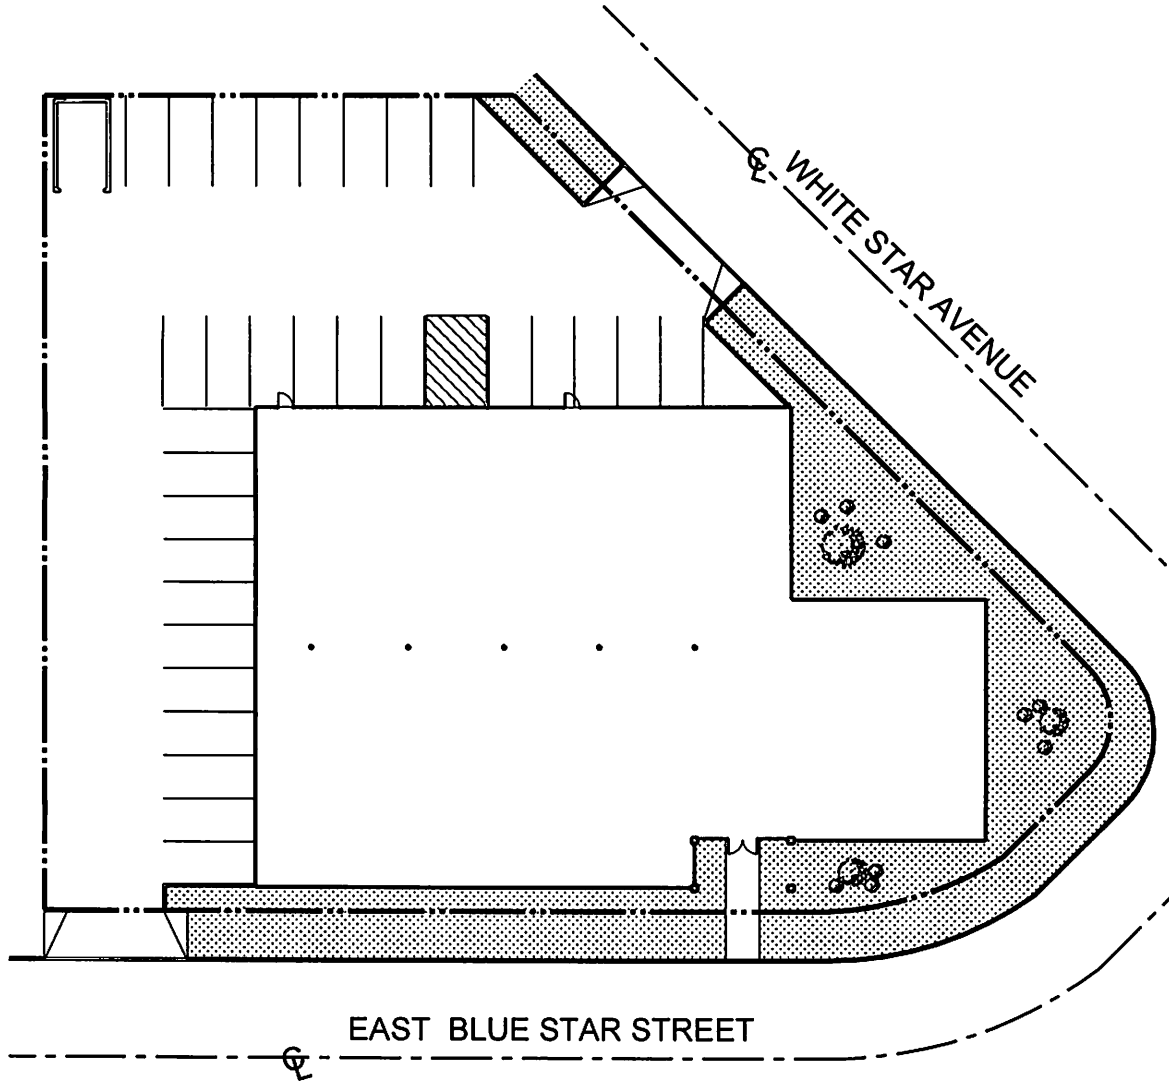

2886 EAST BLUE STAR STREET
ANAHEIM, CA 92806

